


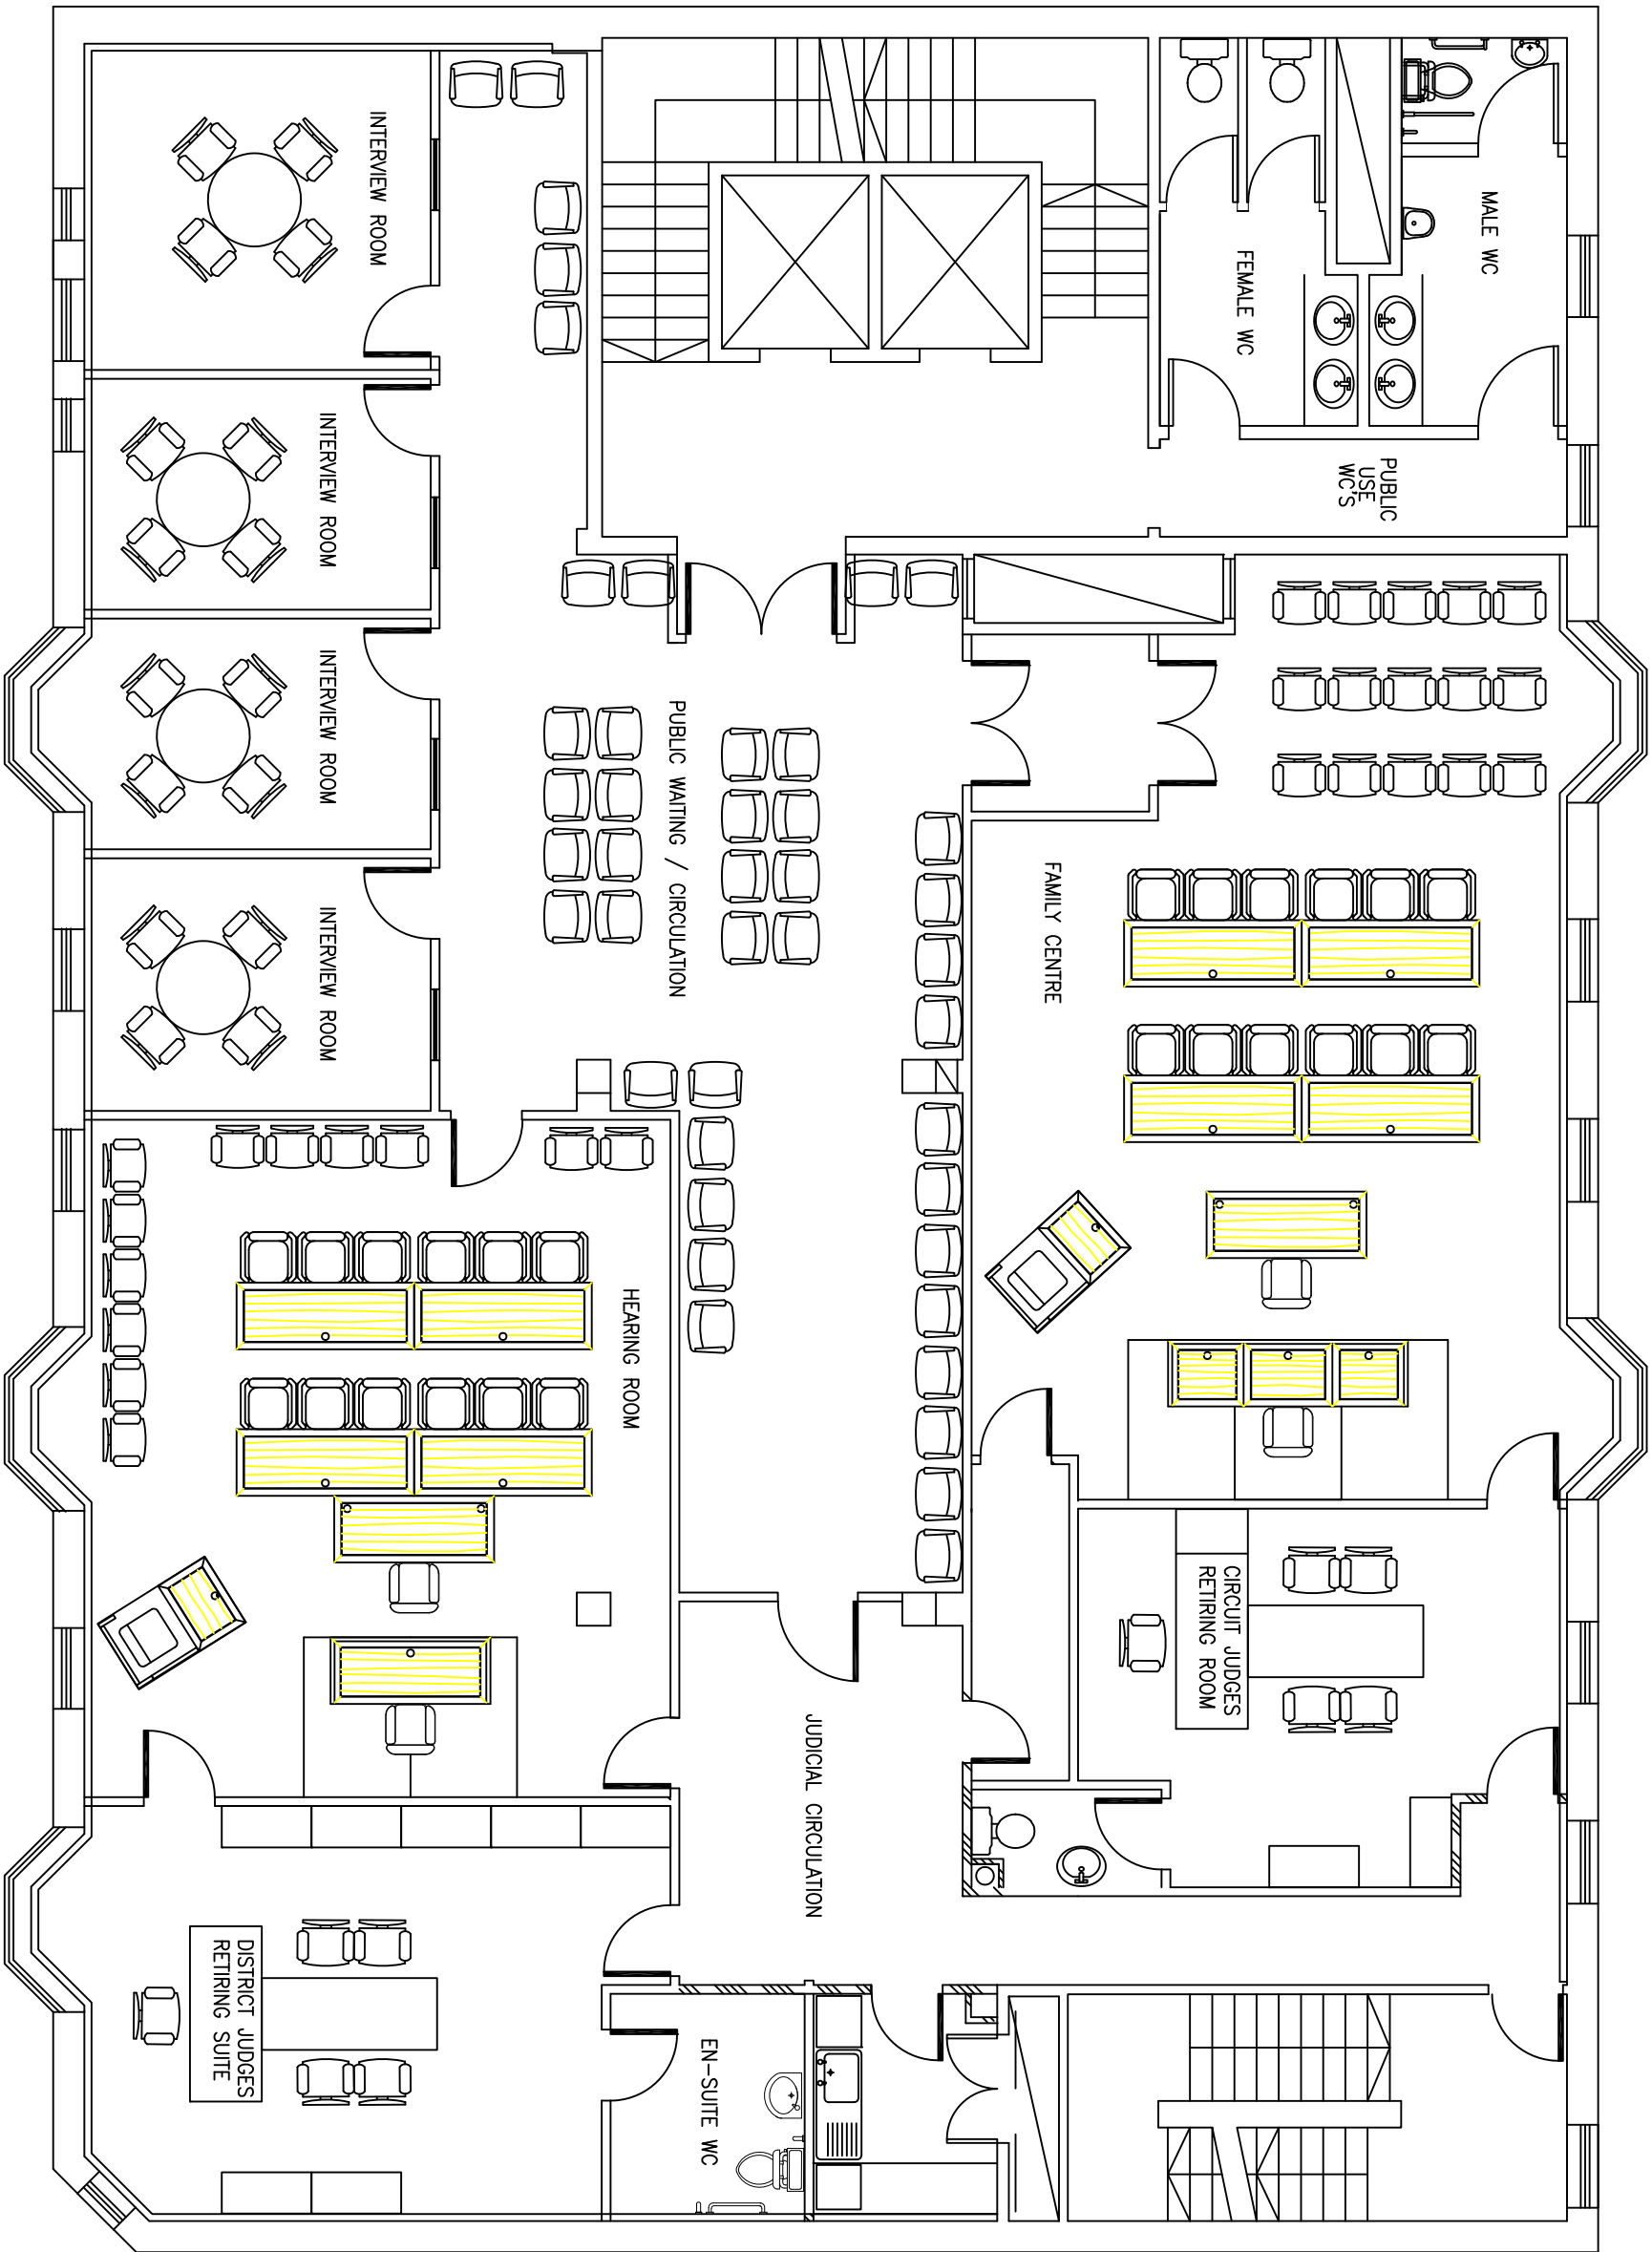

PLEASE TAKE NOTE OF THE FOLLOWING:
This drawing is an integral part of a space analysis exercise.
The layers used in the space analysis system, some of which will not be included in this drawing are:

Area, Boxes, SFT, Split Hatch and SFT Text

Do not **REMOVE** any of these Layers
Do not **DELETE** any item from these Layers
Do not **MOVE** any item between these Layers

Before this plan is returned **EACH** room and space must have its current use entered within its boundaries

Please read the Drawing Protocols which were issued with this Drawing

Thank you for your co-operation

REF	REVISION	DATE
-----	----------	------

PROPERTY AND CONSTRUCTION
MCBAINS COOPER
BUILDING SURVEYING DIVISION
3 CAVENDISH SQUARE
LONDON W1G 0LB
TELEPHONE 020 7 612 0700
FACSIMILE 020 7 612 0701
EMAIL HQ@MCBAINSCOOPER.CO.UK

Client
The Court Service

Project
Brighton County Court
Family Centre

Title
As Built Issue
Second Floor Layout

Scale NTS **Date** MAY 01

Drawn JR **Checked** PD

Drawing No. 48332/11 **Revision No.**