


NOTE:


EVERYTHING WITHIN DASHED RED LINE IS TO BE INSTALLED ON SITE.

ALL GAPS BETWEEN STRUCTURAL ELEMENTS & TIMBER PACKERS& DOOR FRAMES & TIMBERS TO BE FILLED WITH B1 INTUMESCENT FIRE SEALANT.

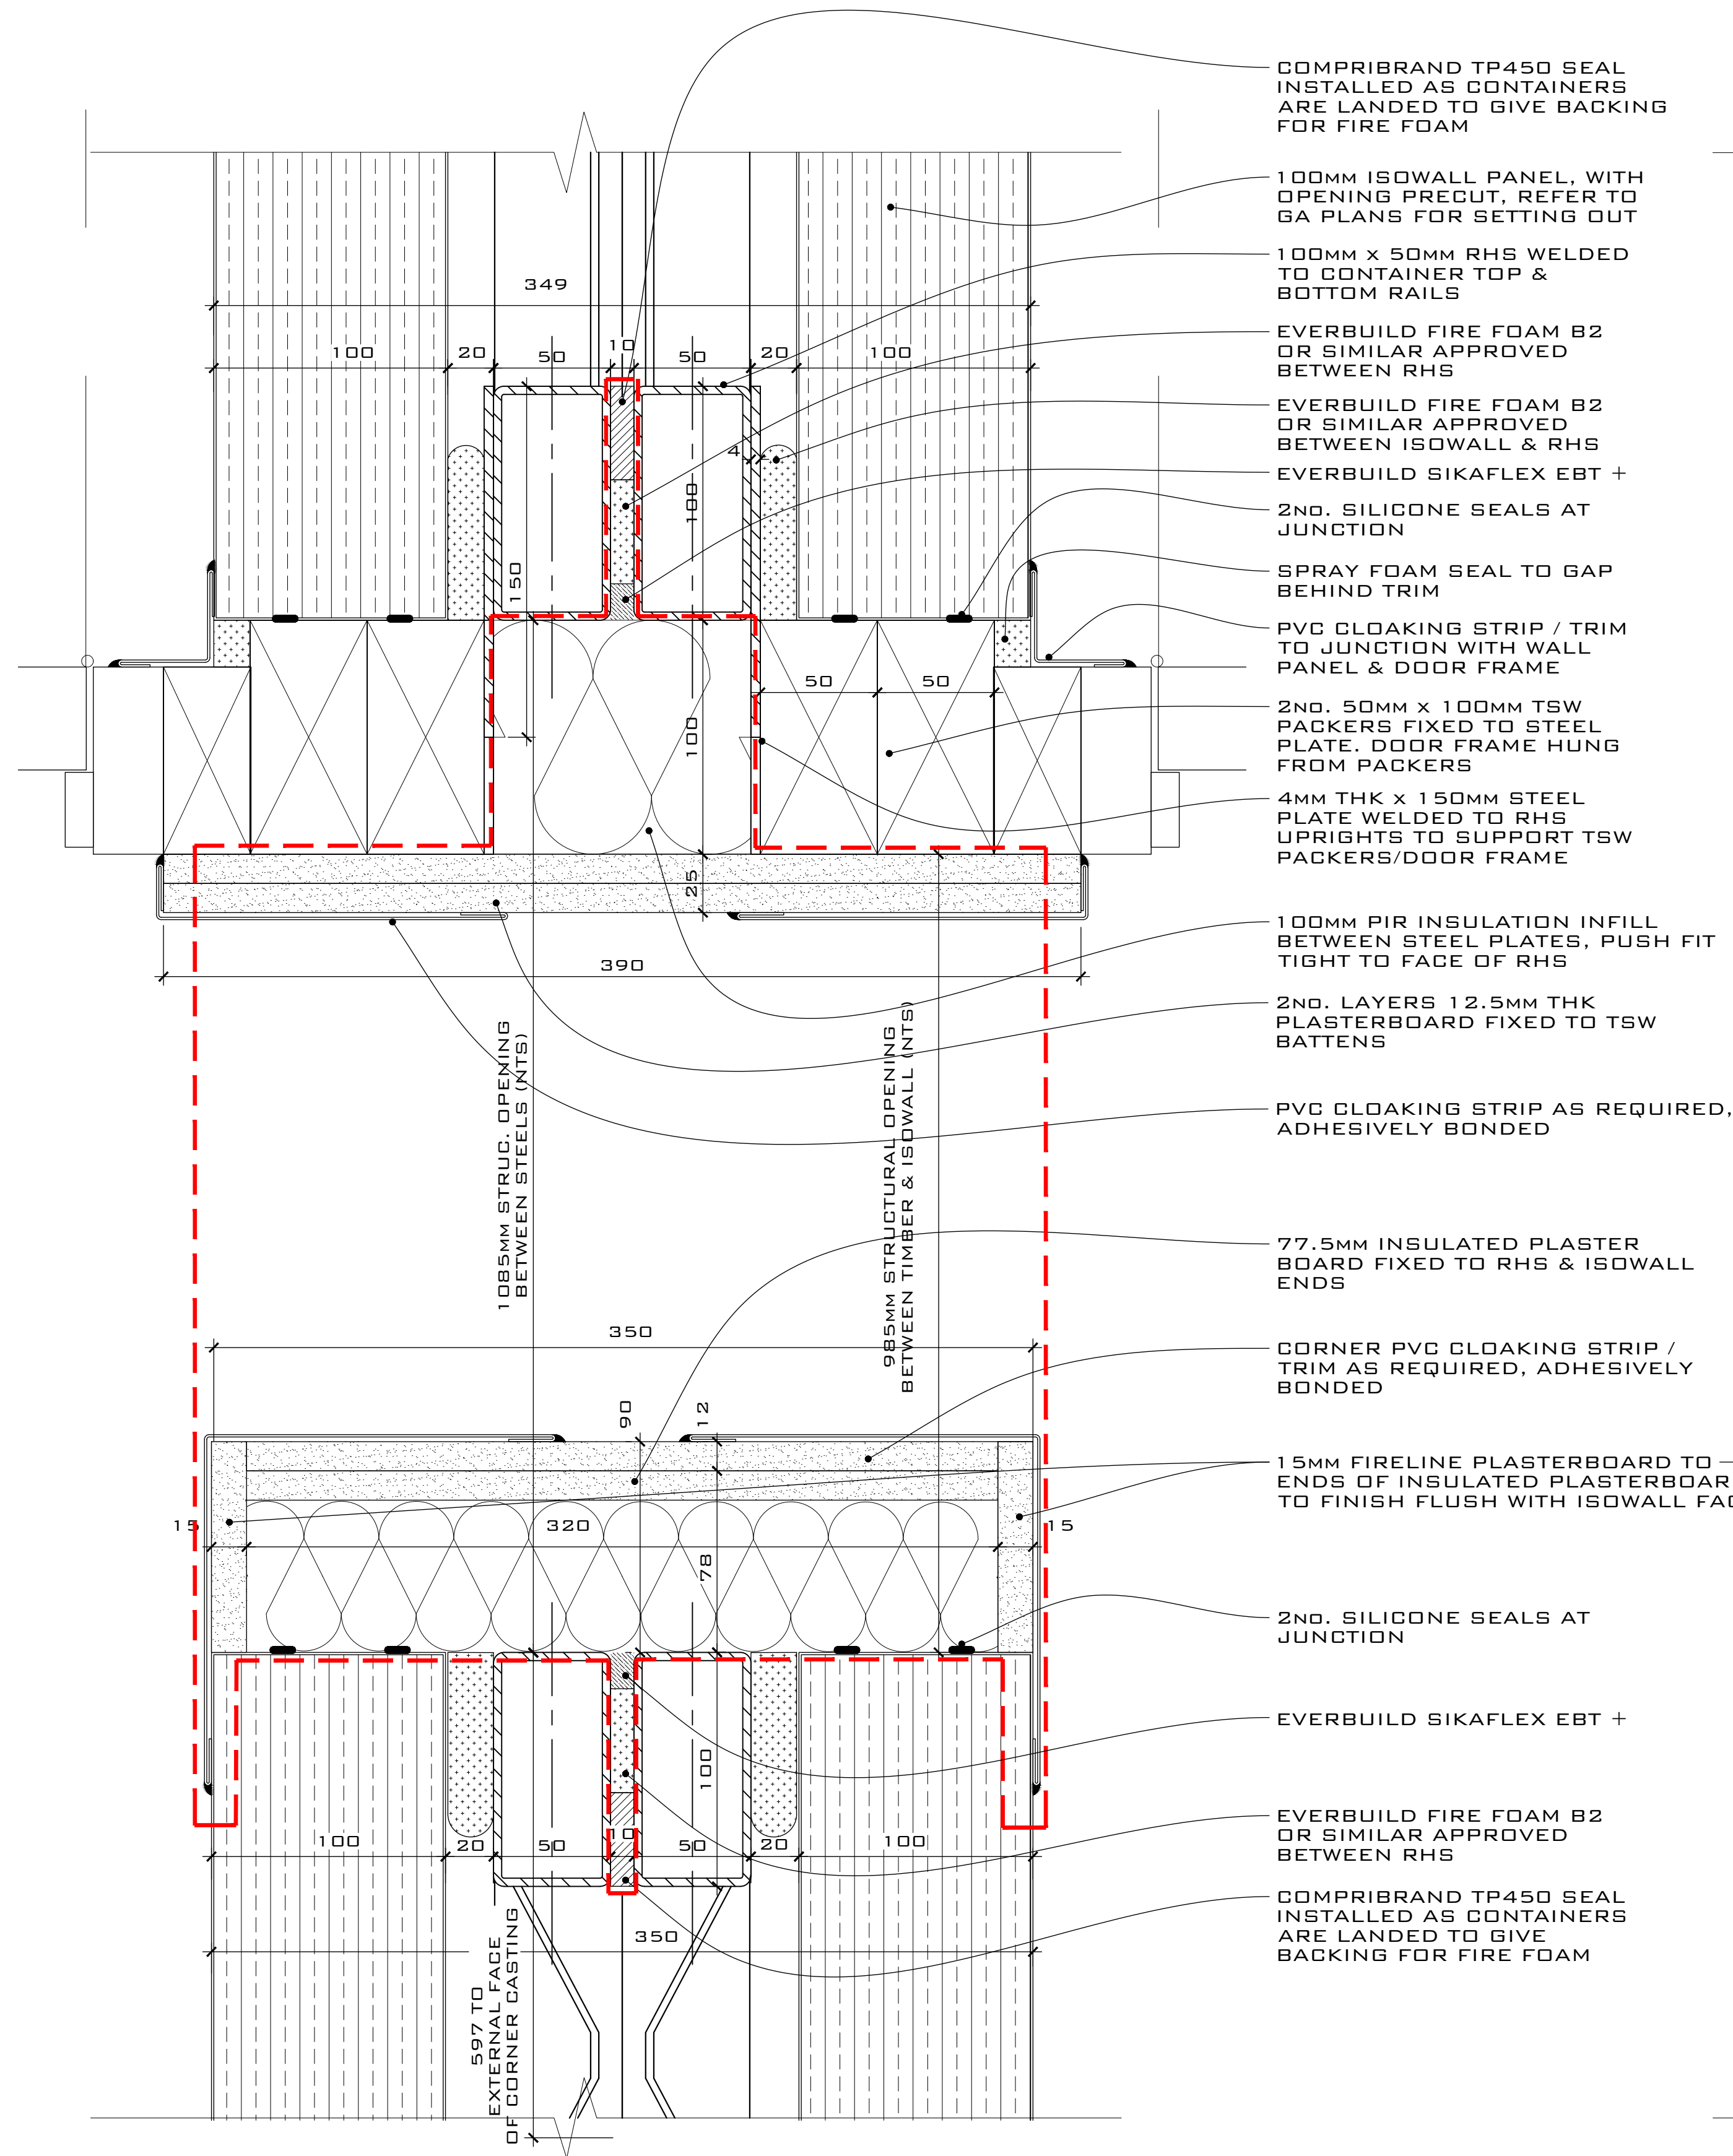

DETAIL 10 - PLAN


1:2 SCALE @ A1

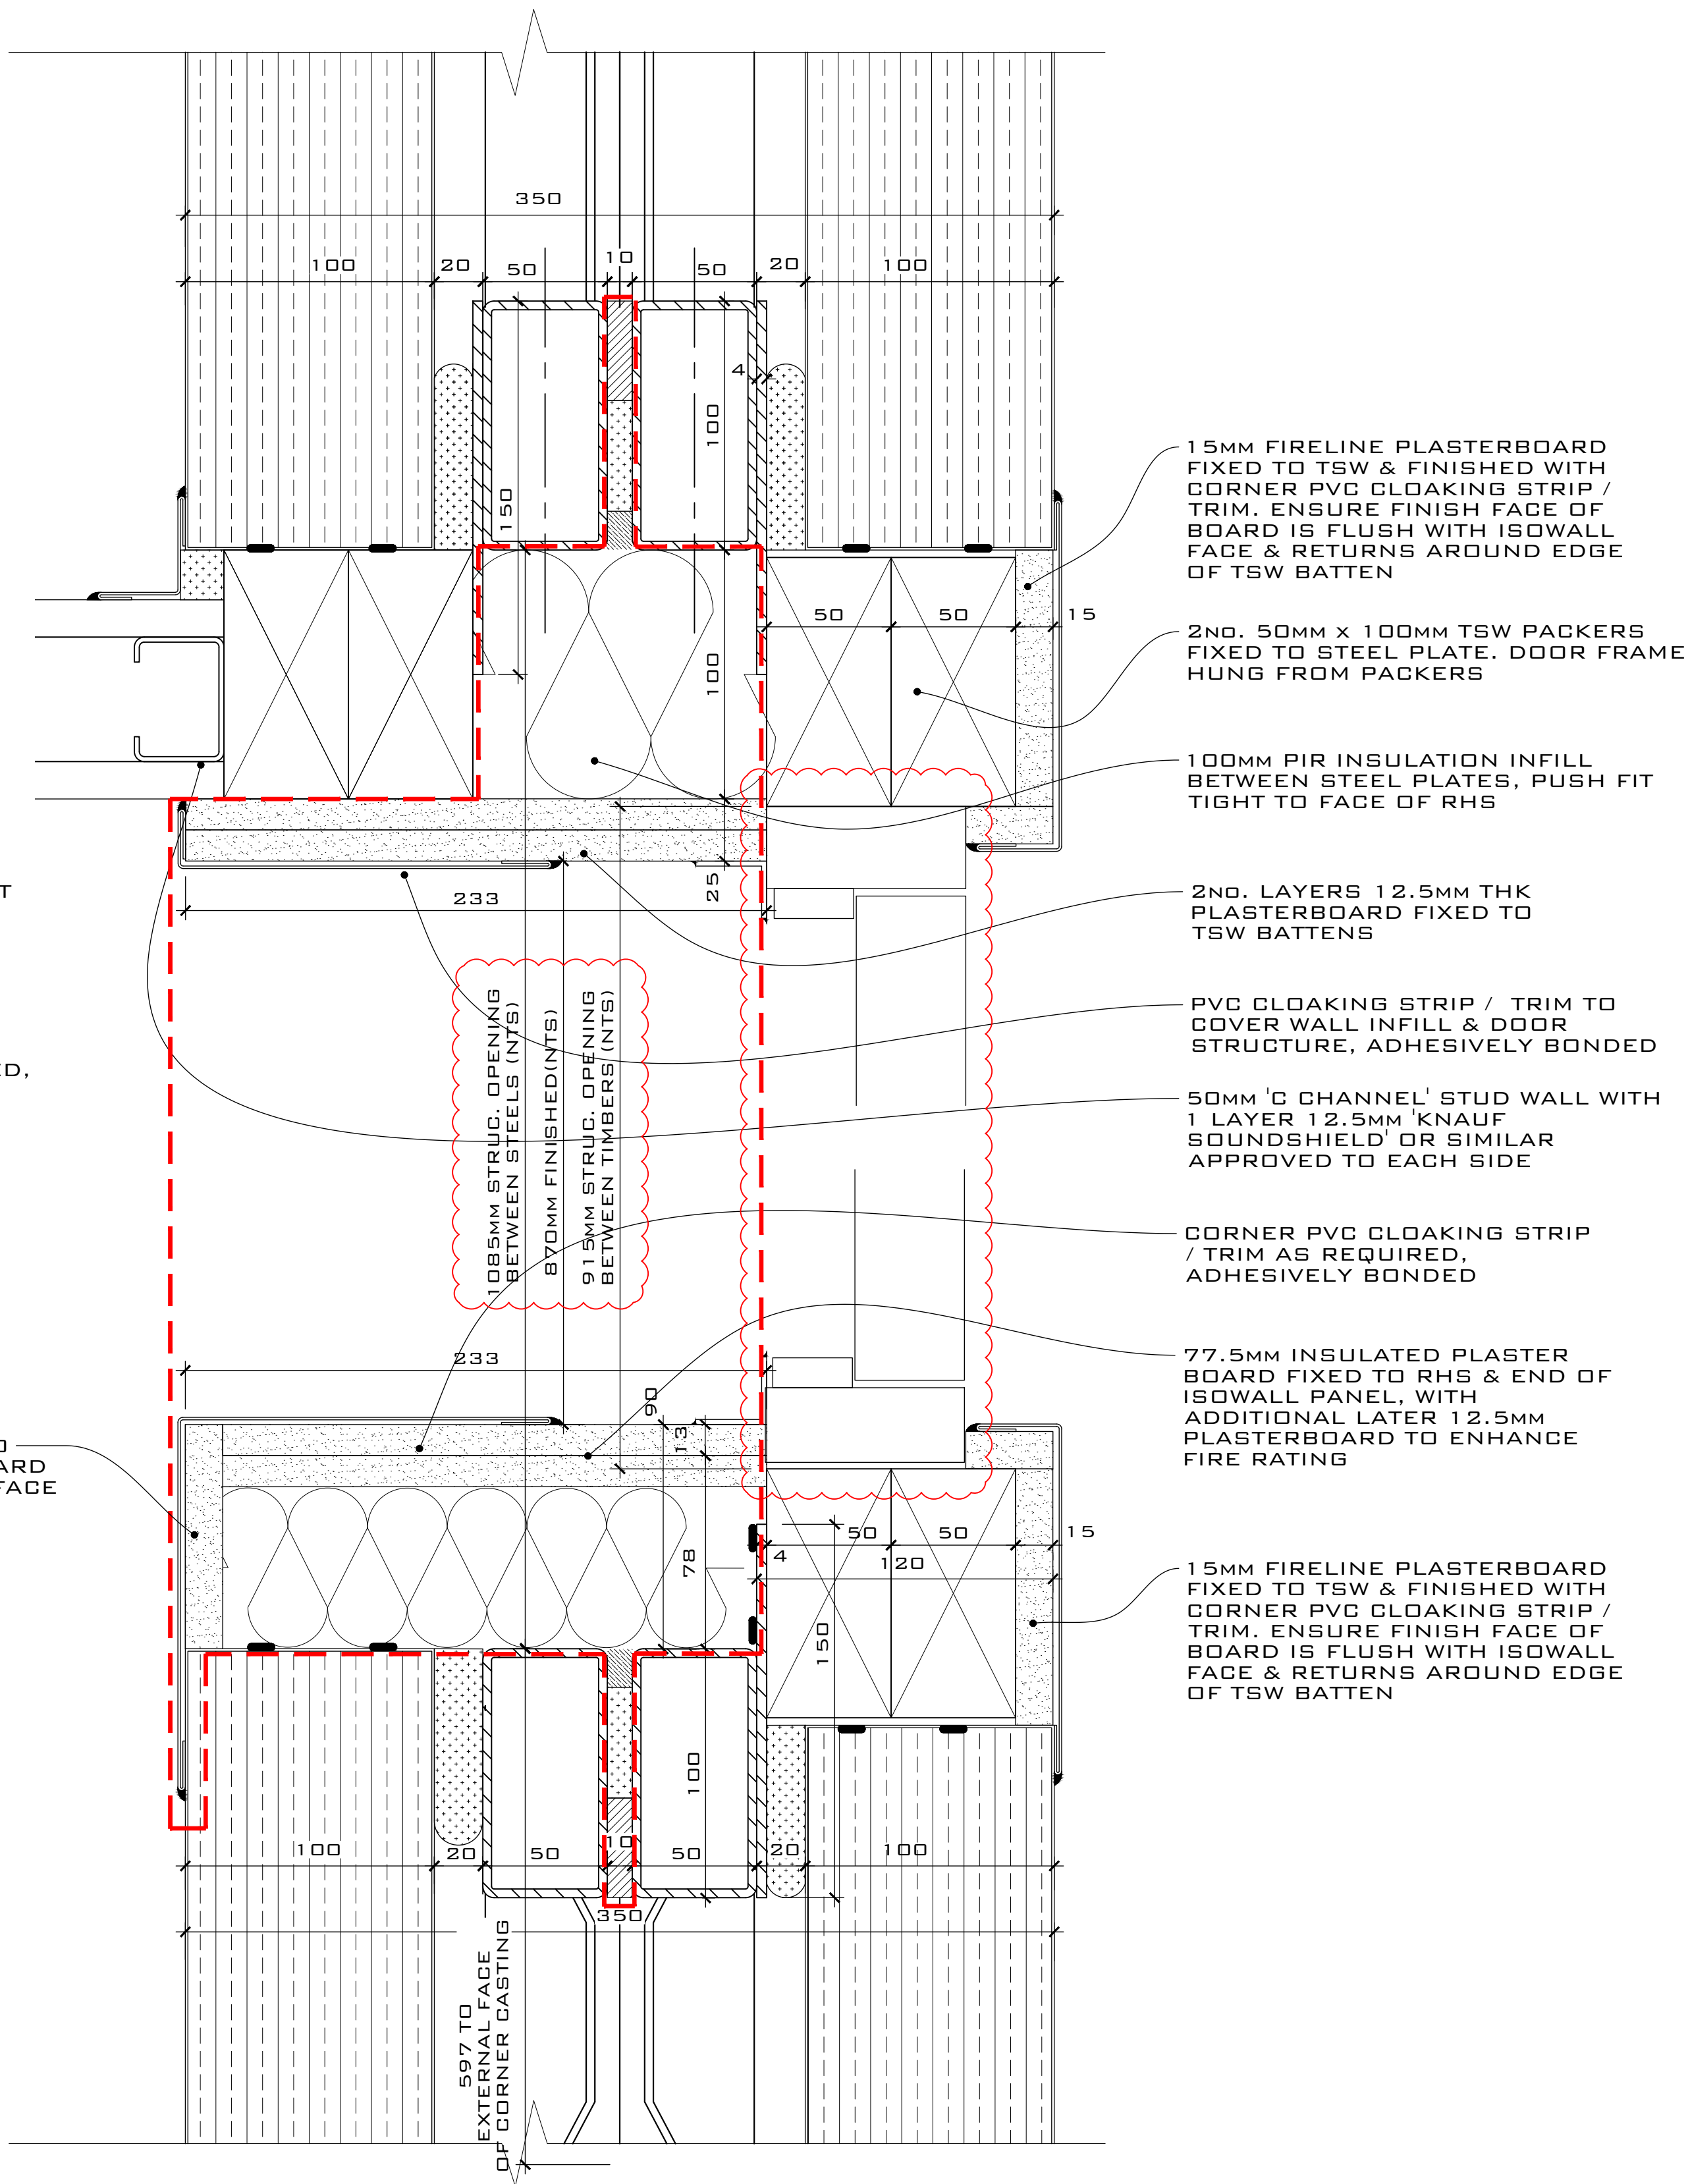

DETAIL 11 - PLAN

1:2 SCALE @ A1

DRAWING SCALE 1:2 @ A1
DRAWING SCALE 1:4 @ A3

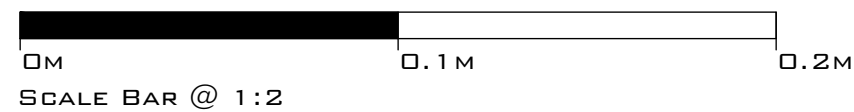

NOTES:

- DRAWINGS SHOULD ONLY BE SCALED FOR PLANNING PURPOSES. DO NOT SCALE FROM THIS DRAWING FOR CONSTRUCTION PURPOSES.
- ALL DIMENSIONS ARE IN MM, UNLESS STATED OTHERWISE.
- ALL DIMENSIONS TO BE CHECKED ON SITE PRIOR TO CONSTRUCTION OR ORDERING.
- ANY ERRORS OR OMISSIONS TO BE NOTIFIED TO CITIZEN LLP IMMEDIATELY.
- CONTRACTOR TO READ & CHECK ALL MANUFACTURES LITERATURE AND IMPLEMENT ITS REQUIREMENTS PRIOR TO INSTALLATION OF ANY MATERIALS AND COMPONENTS.
- CITYZEN LIMITED IS NOT RESPONSIBLE FOR ANY BUILDING WORK THAT IS CARRIED OUT ON SITE.
- THIS DRAWING IS TO BE READ IN CONJUNCTION WITH ALL NECESSARY ARCHITECTURAL, STRUCTURAL AND SPECIALIST DRAWINGS, SPECIFICATIONS, SCOPES OF WORK & ROOM DATA SHEETS.
- ALL MATERIALS AND WORKMANSHIP SHALL CONFORM WITH THE RELEVANT BRITISH AND EUROPEAN STANDARD, SPECIFICATIONS AND CODES OF PRACTICE.
- IF IN ANY DOUBT, ASK.
- WALKWAY DESIGN BY OTHERS. FINAL WALKWAY JUNCTIONS TBC.
- CONTAINER DIMENSIONS CAN VARY. ALL DIMENSIONS SHOULD BE CHECKED BEFORE SITE INSTALLATION.

F	21.07.17	DOOR REVISED TO MATCH PDS LINING SIZE	RS	JS	JS
E	26.06.17	ADDITIONAL FIRE RATING NOTES ADDED	RS	JS	JS
D	23.06.17	REVISED IN LINE WITH CLIENT & CONTRACTORS COMMENTS, DTM 15.06.17	RS	JS	JS
C	02.06.17	REVISED TO CLIENT COMMENTS & DTM 23.05.17, ISSUED FOR CONSTRUCTION	RS	JS	JS
B	21.04.17	ISOWALL PANEL REVISED TO STANDARD PANEL, SOUNDBLOC REMOVED	RS	JS	JS
A	27.03.17	REVISED FOLLOWING DTM & CONTRACTORS COMMENTS, ISOWALL PANEL, DOORSETTING OUT REVISED	RS	JS	JS
REV	DATE	REVISION	DRAWN	CHECKED	APPROVED

COPYRIGHT CITYZEN LIMITED



CLIENT:
CARGOTEK

DESIGNER:
ROMAN SCHNECKER

PROJECT:
CARGOTEK 20FT PRODUCT

TITLE:
TYPICAL DETAILS
10 & 11 JUNCTION DETAILS

SCALE: 1:2 @ A1
DATE: MAR 17

PURPOSE OF DRAWING:
CONSTRUCTION

DRAWING: PROJECT REF - DRG NO. (REVISION)
1705-CR-554 (F)