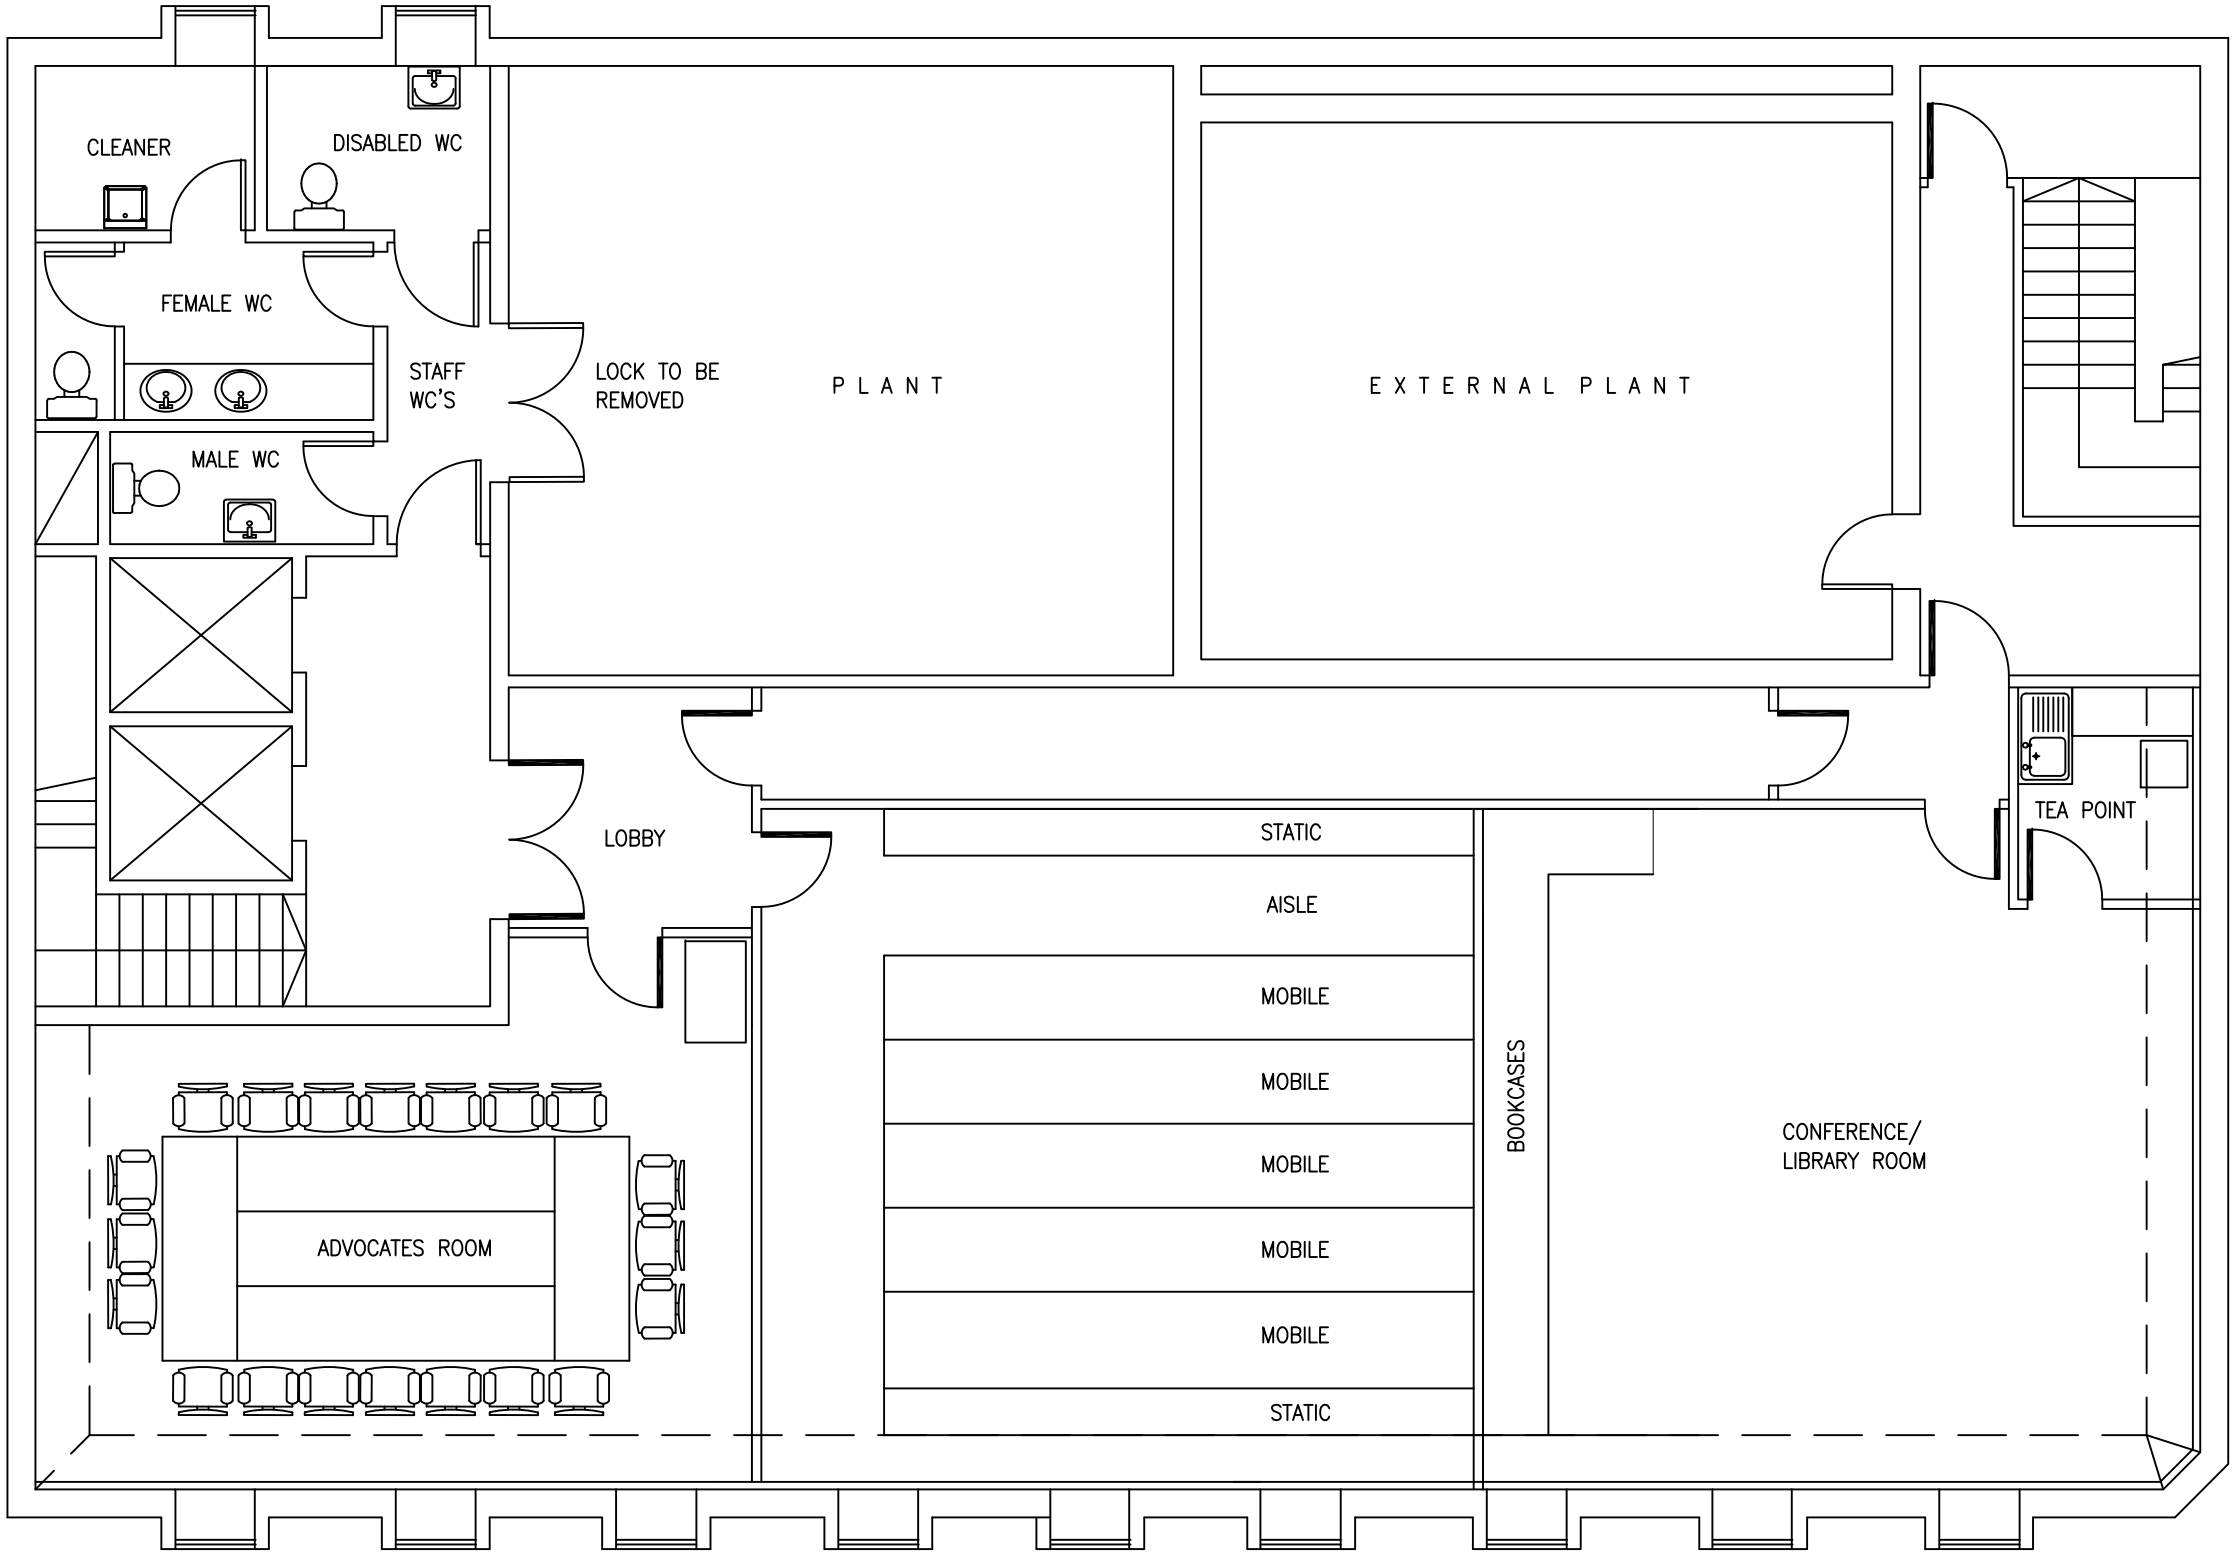

PLEASE TAKE NOTE OF THE FOLLOWING:
This drawing is an integral part of a space analysis exercise.

The layers used in the space analysis system, some of which will not be included in this drawing are:

Area, Boxes, SJT, Split Hatch and SJT Text

Do not **REMOVE** any of these Layers
Do not **DELETE** any item from these Layers
Do not **MOVE** any item between these Layers

Before this plan is returned **EACH** room and space must have its current use entered within its boundaries

Please read the Drawing Protocols which were issued with this Drawing

Thank you for your co-operation

REF	REVISION	DATE

PROPERTY AND CONSTRUCTION
McBAINS COOPER
BUILDING SURVEYING DIVISION
3 CAVENDISH SQUARE
LONDON W1G 0LB
TELEPHONE 020 7612 0700
FACSIMILE 020 7612 0701
EMAIL HQ@MCBAINSCOOPER.CO.UK

Client
The Court Service

Project
Brighton County Court
Family Centre

Title
As Built Issue
Forth Floor Layout

Scale	NTS	Date	MAY 01
Drawn	JR	Checked	PD
Drawing No.	48332/13	Revision No.	